
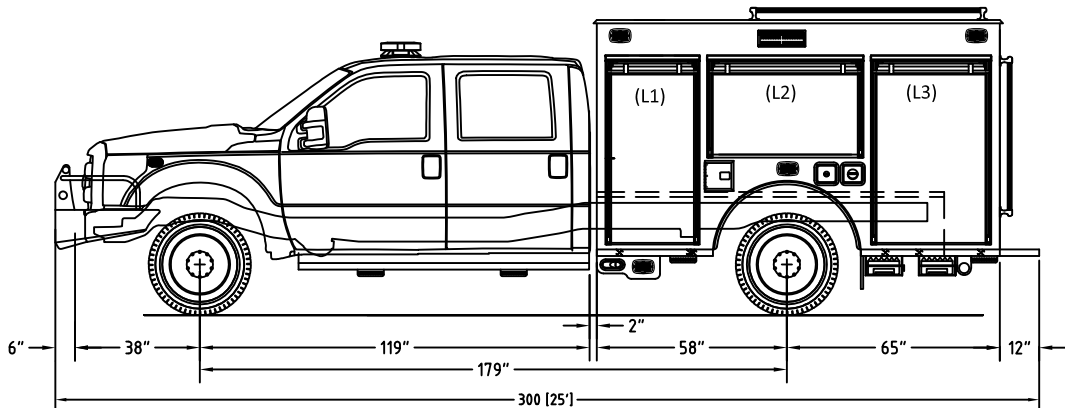
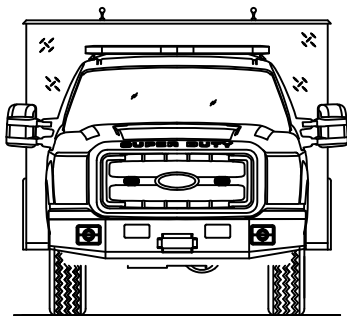
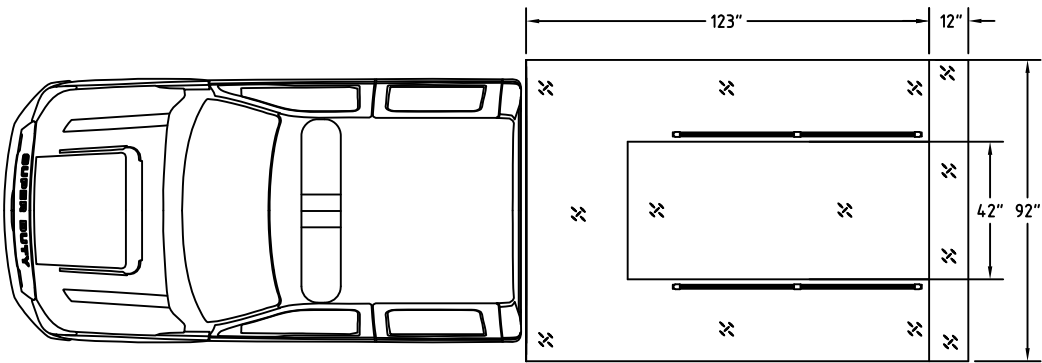
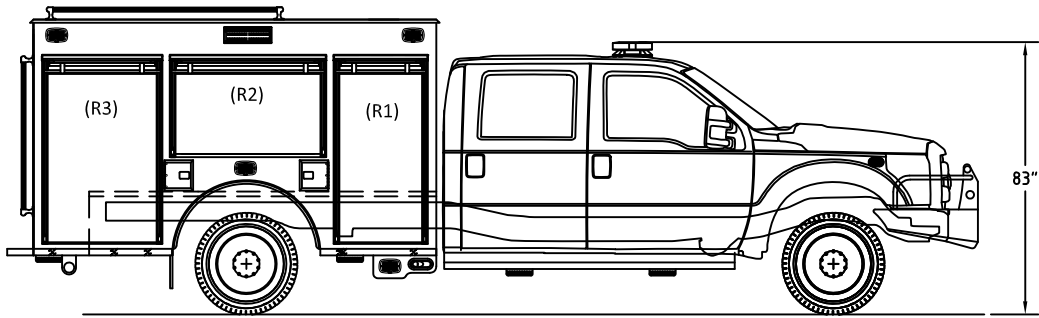


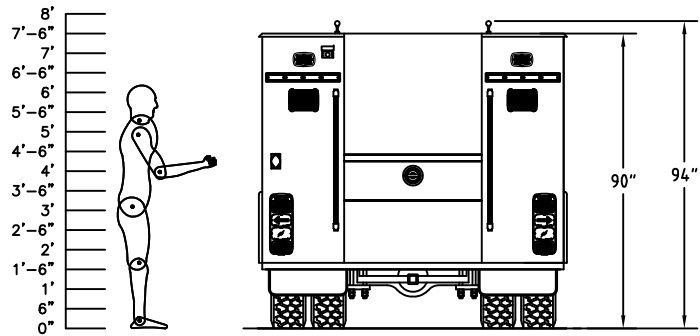

FORD F-550 4 DOOR 4X4  
CUMMINS 6.7 POWER STROKE/ TORQSHIFT  
7,000# FRONT/14,706# REAR  
N/A  
N/A  
N/A

THIS DRAWING IS A GENERAL  
CONFIGURATION AND MAY NOT  
NECESSARILY REFLECT ALL  
CONTRACTUAL REQUIREMENTS.  
CONTRACT SPECIFICATIONS SHALL  
PREVAIL OVER DRAWING.

CUSTOMER APPROVAL:

NAME: \_\_\_\_\_

TITLE: \_\_\_\_\_

DATE: \_\_\_\_\_

|                  |      |                      |       |
|------------------|------|----------------------|-------|
|                  |      |                      |       |
|                  |      |                      |       |
|                  |      |                      |       |
| A                |      | AS BUILT REVISIONS   | JGW   |
| SYM              | DATE | REVISION DESCRIPTION | APP'D |
| SALES ENGINEER : |      | T.B.D.               |       |

|                                                                |          |            |         |
|----------------------------------------------------------------|----------|------------|---------|
| DIMENSIONS ARE APPROXIMATE & MAY VARY DUE TO BUILD ADJUSTMENTS |          |            |         |
| SCALE                                                          | DWG SIZE | DRAWN BY   | DATE    |
| 1"=24"                                                         | D        | Z.ZSCHUNKE | 7-19-16 |
| APPROVED BY D.KELLY                                            |          |            |         |
| LIGHT DUTY RESCUE                                              |          |            |         |
| BOWMANVILLE, NY                                                |          |            |         |
| PROPSOAL DRAWING                                               |          |            |         |



**KME**  
RES GROUP

KME  
ONE INDUSTRIAL COMPLEX - NESQUEHONING, PA 18240